

Section 3. Powers and Duties. The Board of Directors shall have the power and duties necessary for the administration of the affairs of the Condominium and may do all acts and things as are not prohibited by the Condominium Documents as required thereby to be exercised and done by the Co-owners.

Section 4. Other Duties. In addition to the foregoing duties imposed by these Bylaws, or any further duties which may be imposed by resolution of the members of the Association, the Association shall be responsible specifically for the following:

- (a) To manage and administer the affairs of and to maintain the Condominium Project and the Common Elements thereof.
- (b) To levy and collect assessments from the members of the Association and to use the proceeds thereof for the purposes of the Association.
- (c) To carry insurance and collect and allocate the proceeds thereof.
- (d) To rebuild improvements after casualty.
- (e) To contract for and employ persons, firms, corporations or other agents to assist in the management, operation, maintenance and administration of the Condominium Project.
- (f) To acquire, maintain and improve; and to buy, operate, manage, sell, convey, assign, mortgage or lease any real or personal property (including any Unit in the Condominium and easements, rights-of-way and licenses) on behalf of the Association in furtherance of any of the purposes of the Association.
- (g) To borrow money and issue evidences of indebtedness in furtherance of any or all of the purposes of the Association, and to secure the same by mortgage, pledge, or other lien on property owned by the Association; provided, however, that any such action shall also be approved by affirmative vote of 75% of all the members of the Association in number and in value.
- (h) To make rules and regulations in accordance with Article VI, Section 13 of these Bylaws.
- (i) To establish such committees as it deems necessary, convenient or desirable and to appoint persons thereto for the purpose of implementing the administration of the Condominium and to delegate to such committees any functions or responsibilities which are not by law or the Condominium Documents require to be performed by the Board.
- (j) To enforce the provisions of the Condominium Documents.

Section 5. Management Agent. The Board of Directors may employ for the Association a professional management agent (which may include the Developer or any person or entity related thereto), at reasonable compensation established by the Board to perform such duties and services as the Board shall authorize, including, but not limited to, the duties listed in Sections 3 and 4 of this Article, and the Board may delegate to such management agent any other duties or powers which are not by law or by the Condominium Documents required to be performed by or have the approval of the Board of Directors or the members of the Association. In no event shall the Board be authorized to enter into any contract with a professional management agent, or any other contract providing for services by the Developer, sponsor or builder, in which the maximum term is greater than 3 years or which is not terminable by the Association upon 90 days written notice thereof to the other party, and no such contract shall violate the provisions of Section 55 of the Act.

Section 6. Vacancies. Vacancies in the Board of Directors, which occur after the Transitional Control Date caused by any reason other than removal of a Director by a vote of the members of the Association, shall be filled by vote of the majority of the remaining Directors, even though they may constitute less than a quorum, except that the Developer shall be solely entitled to fill the vacancy of any Director whom it is permitted in the first instance to designate. Each person so elected, shall be a Director until a successor is elected at the next annual meeting of the members of the Association. Vacancies among non-developer Co-owners' elected Directors which occur prior to the Transitional Control Date, may be filled only through election by non-developer Co-owners and shall be filled in the manner specified in Section 2(b) of this Article.

Section 7. Removal. At any regular or special meeting of the Association duly called with due notice of the removal action proposed to be taken, any one or more of the Directors may be removed with or without cause by the affirmative vote of more than 50% in number and in value of all of the Co-owners, and a successor may then and there be elected to fill any vacancy thus created. The quorum requirement for the purpose of filling such vacancy shall be the normal 35% requirement set forth in Article VIII, Section 4. Any director whose removal has been proposed by the Co-owners shall be given an opportunity to be heard at the meeting. The Developer may remove and replace any or all of the Directors selected by it at any time or from time to time in its sole discretion. Likewise, any Director selected by the non-developer Co-owners to serve before the First Annual Meeting may be removed before the First Annual Meeting in the same manner set forth in this paragraph for removal of Directors generally.

Section 8. First Meeting. The first meeting of a newly elected Board of Directors shall be held within 10 days of election at such place as shall be fixed by the Directors at the meeting at which such Directors were elected, and no notice shall be necessary to the newly elected Directors in order legally to constitute such meeting, providing a majority of the whole Board shall be present.

Section 9. Regular Meetings. Regular meetings of the Board of Directors may be held at such times and places as shall be determined from time to time by a majority of the Directors, but at least two such meetings shall be held during each fiscal year. Notice of regular meetings of the Board of Directors shall be given to each Director personally, by mail, telephone or telegraph, at least 10 days prior to the date named for such meeting.

Section 10. Special Meetings. Special meetings of the Board of Directors may be called by the President on 3 days notice to each Director given personally, by mail, telephone or telegraph, which notice shall state the time, place and purpose of the meeting. Special meetings of the Board of Directors shall be called by the Secretary in like manner and on like notice on the written request of two Directors.

Section 11. Waiver of Notice. Before or at any meeting of the Board of Directors, any Director may, in writing, waive notice of such meeting and such waiver shall be deemed equivalent to the giving of such notice. Attendance by a Director at any meetings of the Board shall be deemed a waiver of notice by him of the time and place thereof. If all the Directors are present at any meeting of the Board, no notice shall be required and any business may be transacted at such meeting.

Section 12. Quorum. At all meetings of the Board of Directors, a majority of the Directors shall constitute a quorum for the transaction of business, and the acts of the majority of the Directors present at the meeting at which a quorum is present shall be the acts of the Board of Directors. If, at any meeting of the Board of Directors, there be less than a quorum present, the majority of those present may adjourn the meeting to a subsequent time upon 24 hours prior written notice delivered to all Directors not present. At any such adjourned meeting, any business which might have been transacted at the meeting as originally called, may be transacted without further notice. The joinder of a Director in the action of a meeting by signing and concurring in the minutes thereof, shall constitute the presence of such Director for purposes of determining a quorum.

Section 13. First Board of Directors. The actions of the first Board of Directors of the Association or any successors thereto selected or elected before the Transitional Control Date shall be binding upon the Association so long as such Actions are within the scope of the powers and duties which may be exercised generally, by the Board of Directors as provided in the Condominium Documents.

Section 14. Fidelity Bonds. The Board of Directors shall require that all officers and employees of the Association handling or responsible for Association funds shall furnish adequate fidelity bonds. The premiums on such bonds shall be expenses of administration.

ARTICLE XII

OFFICERS

Section 1. Officers. The principal officers of the Association shall be a President, who shall be a member of the Board of Directors, a Vice President, a Secretary and a Treasurer. The Directors may appoint an Assistant Treasurer, and an Assistant Secretary, and such other officers as in their judgment may be necessary. Any two officer, except that of President and Vice President, may be held by one person.

(a) President. The President shall be the chief executive officer of the Association. he shall preside at all meetings of the Association and of the Board of Directors. he shall have all of the general powers and duties which are usually vested in the office of the President of an association, including the power to appoint committees from among the members of the Association from time to time as he may in his discretion deem appropriate to assist in the conduct of the affairs of the Association.

(b) Vice President. The Vice President shall take the place of the President and perform his duties whenever the President shall be absent or unable to act. If neither the President nor the Vice President is able to act, the Board of Directors shall appoint some other member of the Board to so do on an interim basis. The Vice President shall also perform such other duties as shall from time to time be imposed upon him by the Board of Directors.

(c) Secretary. The Secretary shall keep the minutes of all meetings of the Board of Directors and the minutes of all meetings of the members of the Association; he shall have charge of the corporate seal, if any, and of such books and papers as the Board of Directors may direct; and he shall, in general, perform all duties incident to the office of the Secretary.

(d) Treasurer. The Treasurer shall have responsibility for the Association's funds and securities and shall be responsible for keeping full and accurate accounts of all receipts and disbursements in books belonging to the Association. He shall be responsible for the deposit of all monies and other valuable effects in the name and to the credit of the Association, and in such depositories as may, from time to time, be designated by the Board of Directors.

Section 2. Election. The officers of the Association shall be elected annually by the board of Directors at the organizational meeting of each new Board and shall hold office at the pleasure of the Board.

Section 3. Removal. Upon affirmative vote of a majority of the members of the Board of Directors, any officer may be removed either with or without cause, and his successor elected at any regular meeting of the Board of Directors, or at any special meeting of the Board called for such purpose. No such removal action may be taken, however, unless the matter shall have been included in the notice of such meeting. The officer who is proposed to be removed shall be given an opportunity to be heard at the meeting.

Section 4. Duties. The officers shall have such other duties, powers and responsibilities as shall, from time to time, be authorized by the Board of Directors.

ARTICLE XIII

SEAL

The Association may (but need not) have a seal. If the Board determines that the Association shall have a seal, then it shall have inscribed thereon the name of the Association, the words "corporate seal", and "Michigan".

ARTICLE XIV

FINANCE

Section 1. Records. The Association shall keep detailed books of account showing all expenditures and receipts of administration, and which shall specify the maintenance and repair expenses of the Common Elements and any other expenses incurred by or on behalf of the Association and the Co-Owners. Such accounts and all other Association records shall be open for inspection by the Co-Owners and their mortgagees during reasonable working hours. The Association shall prepare and distribute to each Co-Owner at least once a year a financial statement, the contents of which shall be defined by the Association. The books of account shall be reviewed at least annually by qualified independent auditors; provided, however, that such auditors need not be certified public accountants. Any institutional holder of a first mortgage lien on any Unit in the Condominium shall be entitled to receive a copy of such annual audited financial statement within 90 days following the end of the Association's fiscal year upon request therefor. The costs of any such audit and any accounting expenses shall be expenses of administration.

Section 2. Fiscal Year. The fiscal year of the Association shall be an annual period commencing on such date as may be initially determined by the Directors. The commencement date of the fiscal year shall be subject to change by the Directors for accounting reasons or other good cause.

Section 3. Bank. Funds of the Association shall be initially deposited in such bank or savings association as may be designated by the Board of Directors and shall be withdrawn only upon the check or order of such officers, employees or agents as are designated by resolution of the Board of Directors from time to time. The funds may be invested from time to time in accounts or deposit certificates of such bank or savings association as are insured by the Federal Deposit Insurance Corporation or the Federal Savings and Loan Insurance Corporation, and may also be invested in interest-bearing obligations of the United States Government.

ARTICLE XV

INDEMNIFICATION OF OFFICERS AND DIRECTORS

Every Director and officer of the Association shall be indemnified by the Association against all expenses and liabilities, including counsel fees, reasonably incurred by or imposed upon him in connection with any proceeding to which he may be a party or in which he may become involved by reason of his being or having been a Director or officer of the Association, whether or not he is a Director or officer at the time such expenses are incurred, except in such cases wherein the Director or officer is adjudged guilty of willful or wanton misconduct or gross negligence in the performance of his duties; provided that, in the event of any claim for reimbursement or indemnification hereunder based upon a settlement by the Director or officer seeking such reimbursement or indemnification, the indemnification

herein shall apply only if the Board of Directors (with the Director seeking reimbursement abstaining) approves such settlement and reimbursement as being in the best interest of the Association. The foregoing right of indemnification shall be in addition to and not exclusive of all other rights to which such Director or officer may be entitled. At least 10 days prior to payment of any indemnification which is approved, the Board of Directors shall notify all Co-Owners thereof. Further, the Board of Directors is authorized to carry officers' and directors' liability insurance covering acts of the officers and directors of the Association in such amounts as it shall deem appropriate.

ARTICLE XVI

AMENDMENTS

Section 1. Proposal. Amendments to these Bylaws may be proposed by the Board of Directors of the Association acting upon the vote of the majority of the Directors or may be proposed by 1/3 or more in number of the Co-Owners by instrument in writing signed by them.

Section 2. Meeting. Upon any such amendment being proposed, a meeting for consideration of the same shall be duly called in accordance with the provisions of these Bylaws.

Section 3. Voting. These Bylaws may be amended by the Co-Owners at any regular annual meeting or a special meeting called for such purpose by an affirmative vote of not less than two-thirds of all Co-Owners in number and in value. No consent of mortgagees shall be required to amend these Bylaws unless such amendment would materially alter or change the rights of such mortgagees, in which event the approval of two-thirds of the mortgagees shall be required, with each mortgagee to have one vote for each first mortgage held.

Section 4. By Developer. Prior to the sale of all units in the Condominium, these Bylaws may be amended by the Developer without approval from any other person so long as any such amendment does not materially diminish the right of a Co-Owner or mortgagee.

Section 5. When Effective. Any amendment to these Bylaws shall become effective upon recording of such amendment in the office of the Genesee County Register of Deeds.

Section 6. Binding. A copy of each amendment to the Bylaws shall be furnished to every member of the Association after adoption; provided, however, that any amendment to these Bylaws that is adopted in accordance with this Article shall be binding upon all persons who have an interest in the Project, irrespective of whether such persons actually receive a copy of the amendment.

ARTICLE XVII

COMPLIANCE

The Association and all present or future Co-Owners, tenants, future tenants, or any other persons acquiring an interest in or using the Project in any manner, are subject to and shall comply with the Act, as amended, and the mere acquisition, occupancy or rental of any Unit or an interest therein or the utilization of or entry upon the Condominium Premises shall signify that the Condominium Documents are accepted and ratified. In the event the Condominium Documents conflict with the provisions of the Act, the Act shall govern.

ARTICLE XVIII**DEFINITIONS**

All terms used herein shall have the same meaning as set forth in the Master Deed to which these Bylaws are attached as an Exhibit or as set forth in the Act.

ARTICLE XIX**REMEDIES FOR DEFAULT**

Any default by a Co-Owner shall entitle the Association or another Co-Owner or Co-Owners to the following relief:

Section 1. Legal Action. Failure to comply with any of the terms or provisions of the Condominium Documents shall be grounds for relief, which may include, without intending to limit the same, an action to recover sums due for damages, injunctive relief, foreclosure of lien (if default in payment of assessment) or any combination thereof, and such relief may be sought by the Association or, if appropriate, by an aggrieved Co-Owner or Co-Owners.

Section 2. Recovery of Costs. In any proceeding arising because of an alleged default by any Co-Owner, the Association, if successful, shall be entitled to recover the costs of the proceeding and such reasonable attorney's fees (not limited to statutory fees) as may be determined by the court, but in no event shall any Co-Owner be entitled to recover such attorney's fees.

Section 3. Removal and Abatement. The violation of any of the provisions of the Condominium Documents shall also give the Association or its duly authorized agents the right, in addition to the rights set forth above, to enter upon the Common Elements or upon any Unit (but not inside any residence), where reasonably necessary and summarily remove and abate, at the expense of the Co-Owner in violation, any structure, thing or condition existing or maintained contrary to the provisions of the Condominium Documents. The Association shall have no liability to any Co-Owner arising out of the exercise of its removal and abatement power authorized herein.

Section 4. Assessment of Fines. The violation of any of the provisions of the Condominium Documents by any Co-Owner shall be grounds for assessment by the Association, acting through its duly constituted Board of Directors, of monetary fines for such violations. No fine may be assessed unless in accordance with the provisions of Article XX hereof.

Section 5. Non-waiver of Right. The failure of the Association or of any Co-Owner to enforce any right, provision, covenant or condition which may be granted by the Condominium Documents shall not constitute a waiver of the right of the Association or of any such Co-Owner to enforce such right, provision, covenant or condition in the future.

Section 6. Cumulative Rights, Remedies and Privileges. All rights, remedies and privileges granted to the Association or any Co-Owner or Co-Owners pursuant to any terms, provisions, covenants or conditions of the aforesaid Condominium Documents shall be deemed to be cumulative, and the exercise of any one or more shall not be deemed to constitute an election of remedies, nor shall it preclude the party, thus exercising the same from exercising such other and additional rights, remedies or privileges as may be available to such party at law or in equity.

Section 7. Enforcement of Provisions of Condominium Documents. A Co-Owner may maintain an action against the Association and its officers and Directors to compel such persons to enforce the terms and provisions of the Condominium Documents. A Co-Owner may maintain an action

against any other Co-Owner(s) for injunctive relief or for damages or any combination thereof for noncompliance with the terms and provisions of the Condominium Documents or the Act.

ARTICLE XX

ASSESSMENT OF FINES

Section 1. General. The violation by any Co-Owner, occupant or guest of any provisions of the Condominium Documents, including any duly adopted rules and regulations, shall be grounds for assessment by the Association, acting through its duly constituted Board of Directors, of monetary fines against the involved Co-Owner. Such Co-Owner shall be deemed responsible for such violations whether they occur as a result of his personal actions or the action of his family, guests, tenants or any other person admitted through such Co-Owner to the Condominium Premises.

Section 2. Procedures. Upon any such violation being alleged by the Board, the following procedures will be followed:

(a) Notice. Notice of the violation, including the Condominium Document provision violated, together with a description of the factual nature of the alleged offense set forth with such reasonable specificity as will place the Co-Owner on notice as to the violation, shall be sent by first class mail, postage prepaid, or personally delivered to the representative of said Co-Owner at the address as shown in the notice required to be filed with the Association pursuant to Article VIII, Section 3 of the Bylaws.

(b) Opportunity to Defend. The offending Co-Owner shall have an opportunity to appear before the Board and offer evidence in defense of the alleged violation. The appearance before the Board shall be at its next scheduled meeting, but in no event shall the Co-Owner be required to appear less than 10 days from the date of the Notice.

(c) Default. Failure to respond to the Notice of Violation constitutes a default.

(d) Hearing and Decision. Upon appearance by the Co-Owner before the Board and presentation of evidence of defense, or, in the event of the Co-Owner's default, the Board shall, by majority vote of a quorum of the Board, decide whether a violation has occurred. The Board's decision is final.

Section 3. Amounts. Upon violation of any of the provisions of the Condominium Documents, and after default of the offending Co-Owner or upon the decision of the Board as recited above, the following fines shall be levied:

(a) First Violation. No fine shall be levied.

(b) Second Violation. Twenty-Five (\$25.00) Dollars fine.

(c) Third Violation. Fifty (\$50.00) Dollars fine.

(d) Fourth Violation and Subsequent Violations. One Hundred (\$100.00) Dollars fine.

Section 4. Collection. The fines levied pursuant to Section 3 above shall be assessed against the Co-Owner and shall be due and payable together with the regular Condominium assessment on the first of the next following month. Failure to pay the fine will subject to Co-Owner to all liabilities set forth in the Condominium Documents including, without limitation, those described in Article II and Article XIX of the Bylaws.

ARTICLE XXI**RIGHTS RESERVED TO DEVELOPER**

Any or all of the rights and powers granted or reserved to the Developer in the Condominium Documents or by law, including the right and power to approve or disapprove any act, use, or proposed action or any other matter or thing, may be assigned by it to any other entity or to the Association. Any such assignment or transfer shall be made by appropriate instrument in writing in which the assignee or transferee shall join for the purpose of evidencing its acceptance of such powers and rights and such assignee or transferee shall thereupon have the same rights and powers as herein given and reserved to the Developer. Any rights and powers reserved or granted to the Developer or its successors shall terminate, if not sooner assigned to the Association, at the conclusion of the Development and Sales Period as defined in Article III of the Master Deed. The immediately preceding sentence dealing with the termination of certain rights and powers granted or reserved to the Developer is intended to apply, insofar as the Developer is concerned, only to the Developer's rights to approve and control the administration of the Condominium and shall not, under any circumstances, be construed to apply to or cause the termination of any real property rights granted or reserved to the Developer or its successors and assigns in the Master Deed or elsewhere (including, but not limited to, access easements, utility easements and all other easements created and reserved in such documents which shall not be terminable in any manner hereunder and which shall be governed only in accordance with the terms of their creation or reservations and not hereby).

ARTICLE XXII**SEVERABILITY**

In the event that any of the terms, provisions or covenants of these Bylaws or the Condominium Documents are held to be partially or wholly invalid or unenforceable for any reason whatsoever, such holding shall not affect, alter, modify or impair in any manner whatsoever any of the other terms, provisions or covenants of such documents or the remaining portion of any terms, provisions or covenants held to be partially invalid or unenforceable.

GENESEE COUNTY CONDOMINIUM
SUBDIVISION PLAN NO. 210

EXHIBIT "B" TO THE MASTER DEED OF
LINDEN OAKS
TOWNSHIP OF ARGENTINE, GENESEE
COUNTY, MICHIGAN

DEVELOPERS:

"CRD DEVELOPMENT, L.C."
11661 PARKIN LANE
FENTON, MI 48430
(810) 629-3121

LEGAL DESCRIPTION:

[illegible]

SHEET INDEX:

TITLE SHEET
SURVEY PLAN
SITE PLAN
UTILITY PLAN

4 4 4
OF OF
1 2 3 4



ENGINEER:

TRANS ENVIRONMENTAL ENGINEERS, INC.
G-3504B CORUNNA ROAD
FLINT, MICHIGAN 48532
(810) 235-1000

AS BUILT
REGISTRATION NO. 82610
REGISTERED PROFESSIONAL ENGINEER
HANDMAN KARUR

PROPOSED DATE:

DATE:

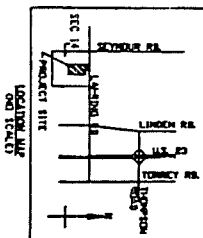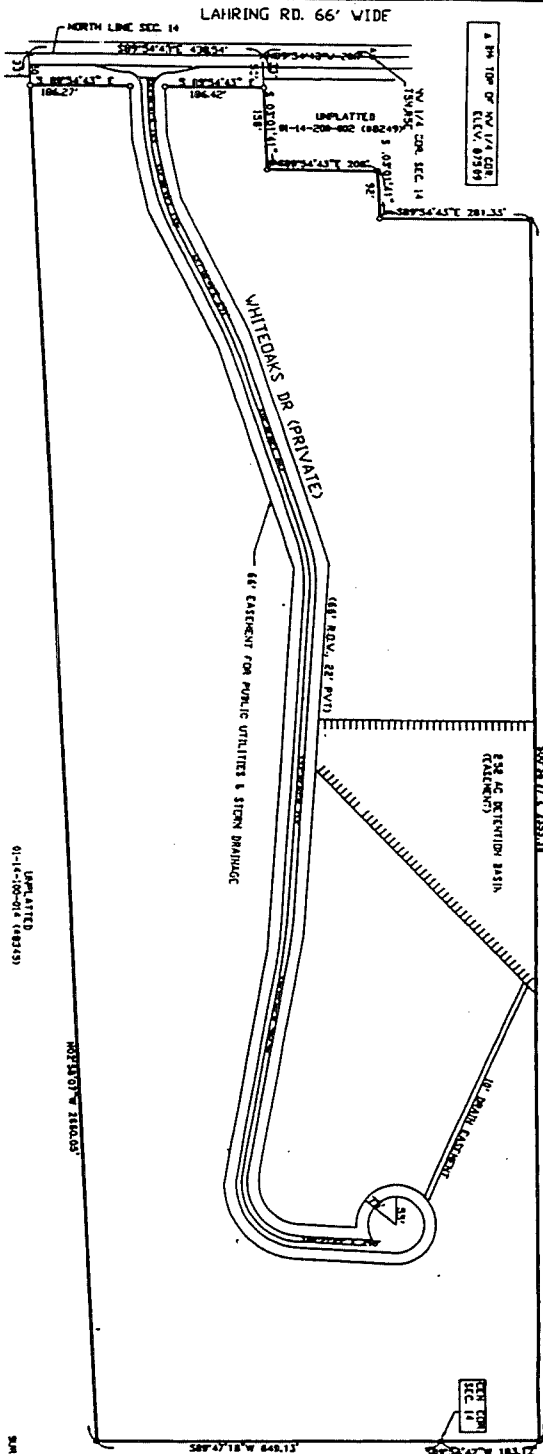

SURVEY PLAN

SECTION 14 ARGENTINE TOWNSHIP, GENESSEE COUNTY


[illegible]

NOTES:
ALL DISTANCES SHOWN ARE IN FEET AND DECIMALS THERE OF.
THE SYMBOL * INDICATES A CONCRETE MONUMENT.

ENGINEER
No. 1
2031

Shreehan Mann
HANNAN MANN
REGISTERED PROFESSIONAL ENGINEER
REGISTRATION NO. 82610
AS BUILT

PROPOSED DATE:

DATE:

CRD DEVELOPMENT L.C.
11661 PARKIN LANE
FENTON, MICHIGAN 48430
(810) 429-3121

LINDEN OAKS
SEC 14 ARGENTINE TOWNSHIP
GENESEE COUNTY, MICHIGAN

TRANS ENVIRONMENTAL ENGINEERS INC.
G-3304B CORUNNA ROAD
FLINT, MICHIGAN 48532
PH. (810) 235-1000

SURVEY PLAN

SHEET NO. 2 OF 4

UNCLASSIFIED
01-14-100-014 (40343)





J. H. Mendenhall

(Signature)

374198


